


Safety Health and Environmental Information Box

Construction Risks, Maintenance/Cleaning Risks, Demolition/Adaptation Risks:

Drawing Notes

Key
--- 1st floor slab outline

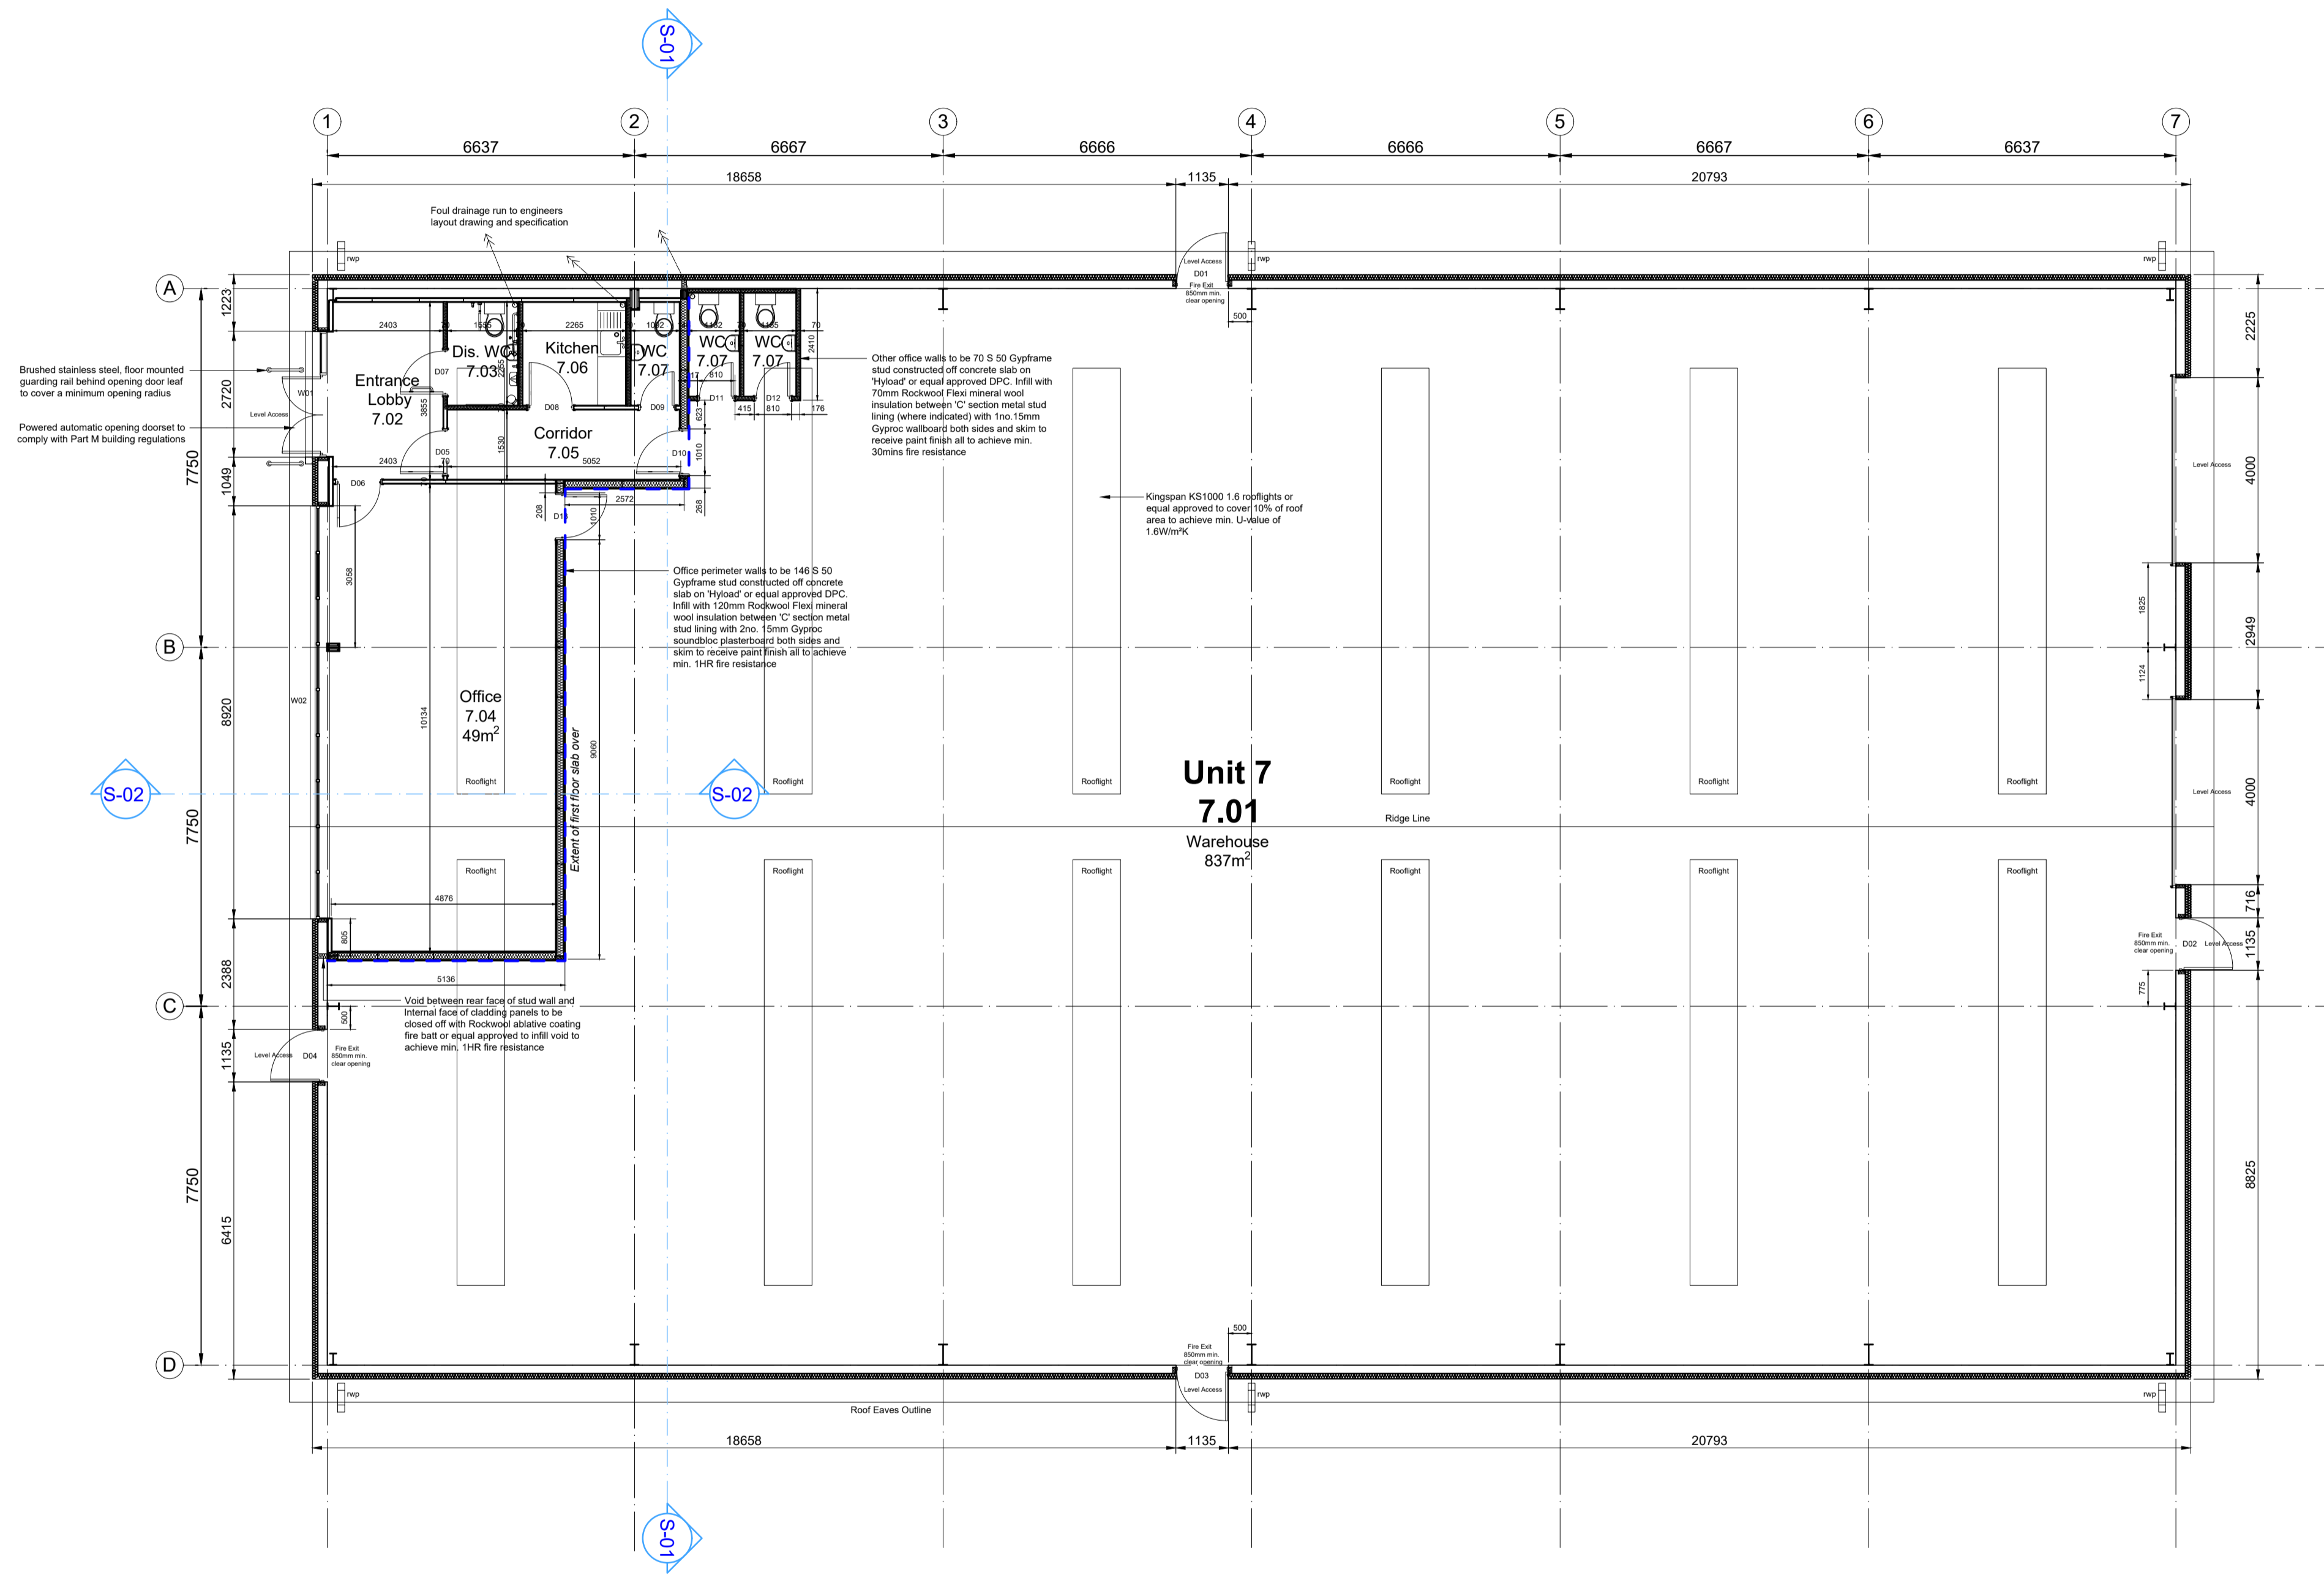

01 GENERAL ARRANGEMENT PLAN (1:100)

Rev	Description	Drawn By	Date
AS BUILT			



Telford & Wrekin Council | bit | Wellington Civic Offices | Telford | Shropshire | PO Box 457 | TF2 2FH | T: 01952 384 500 | W: www.bit-group.co.uk

Client:
TWC

Project:
Ni-Park,
Phase 2 Development

Drawing Title:
Unit 7 Proposed Floorplans

Drawn: JA	Checked: JA	Date: 26.06.23
Scale: 1:100	Sheet Size: A1	Drawing Revision: 00

Project	Originator	Zone	Level	Type	Risk	Number
22293	bit	00	XX	DR	A	08240