


**Safety Health and Environmental Information Box**

Construction Risks, Maintenance/Cleaning Risks, Demolition/Adaptation Risks:

**Drawing Notes**

**Key**

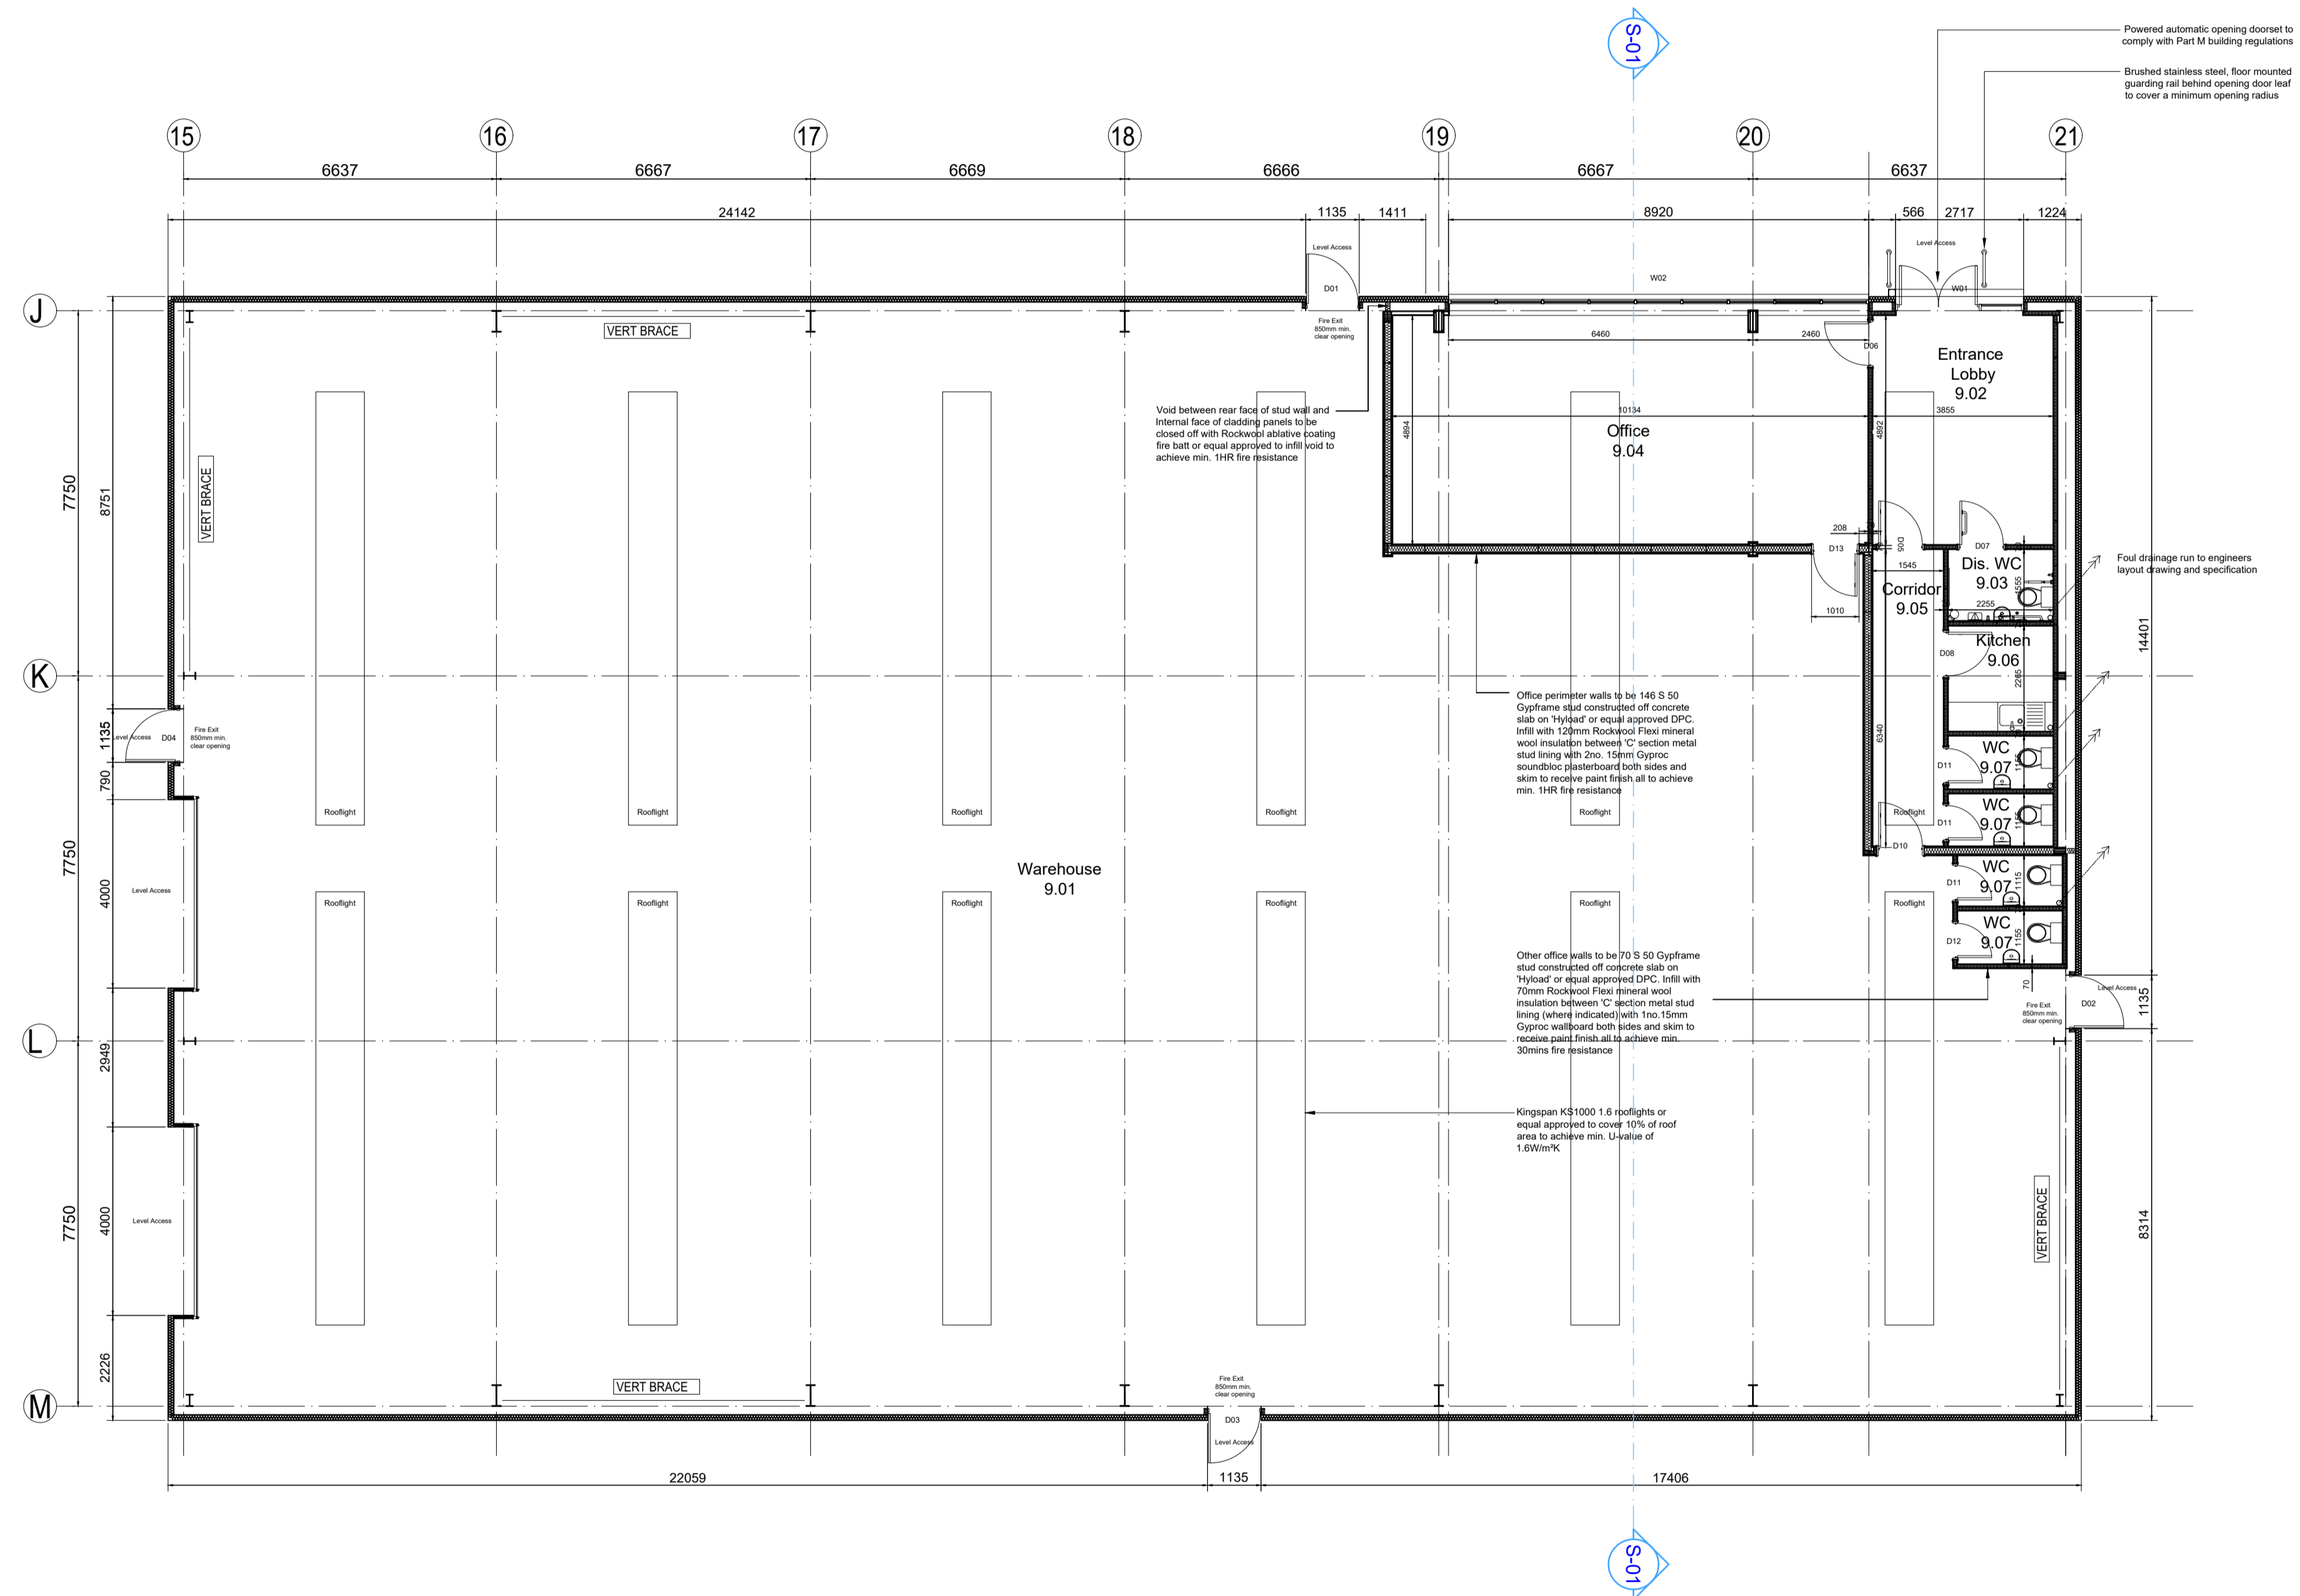

01 GENERAL ARRANGEMENT PLAN (1:100)

Rev	Description	Drawn By	Date
Stage			
AS BUILT			



Telford & Wrekin Council | bit | Wellington Civic Offices | Telford | Shropshire | PO Box 457 | TF2 2FH | T: 01952 384 500 | W: www.bit-group.co.uk

Client:						
TWC						
Project:						
Ni-Park, Phase 2 Development						
Drawing Title:						
Unit 9 Proposed Floorplans						
Drawn:	Checked:	Date:				
JA		26.06.23				
Scale:	Sheet Size:	Drawing Revision:				
1:100	A1	00				
Drawing Number:						
Project:	Originator:	Zone:	Level:	Type:	Risk:	Number:
22293	bit	00	XX	DR	AR	08260